


NOTES:
All dimensions for building work and built in items to be checked on site and not scaled from this drawing.

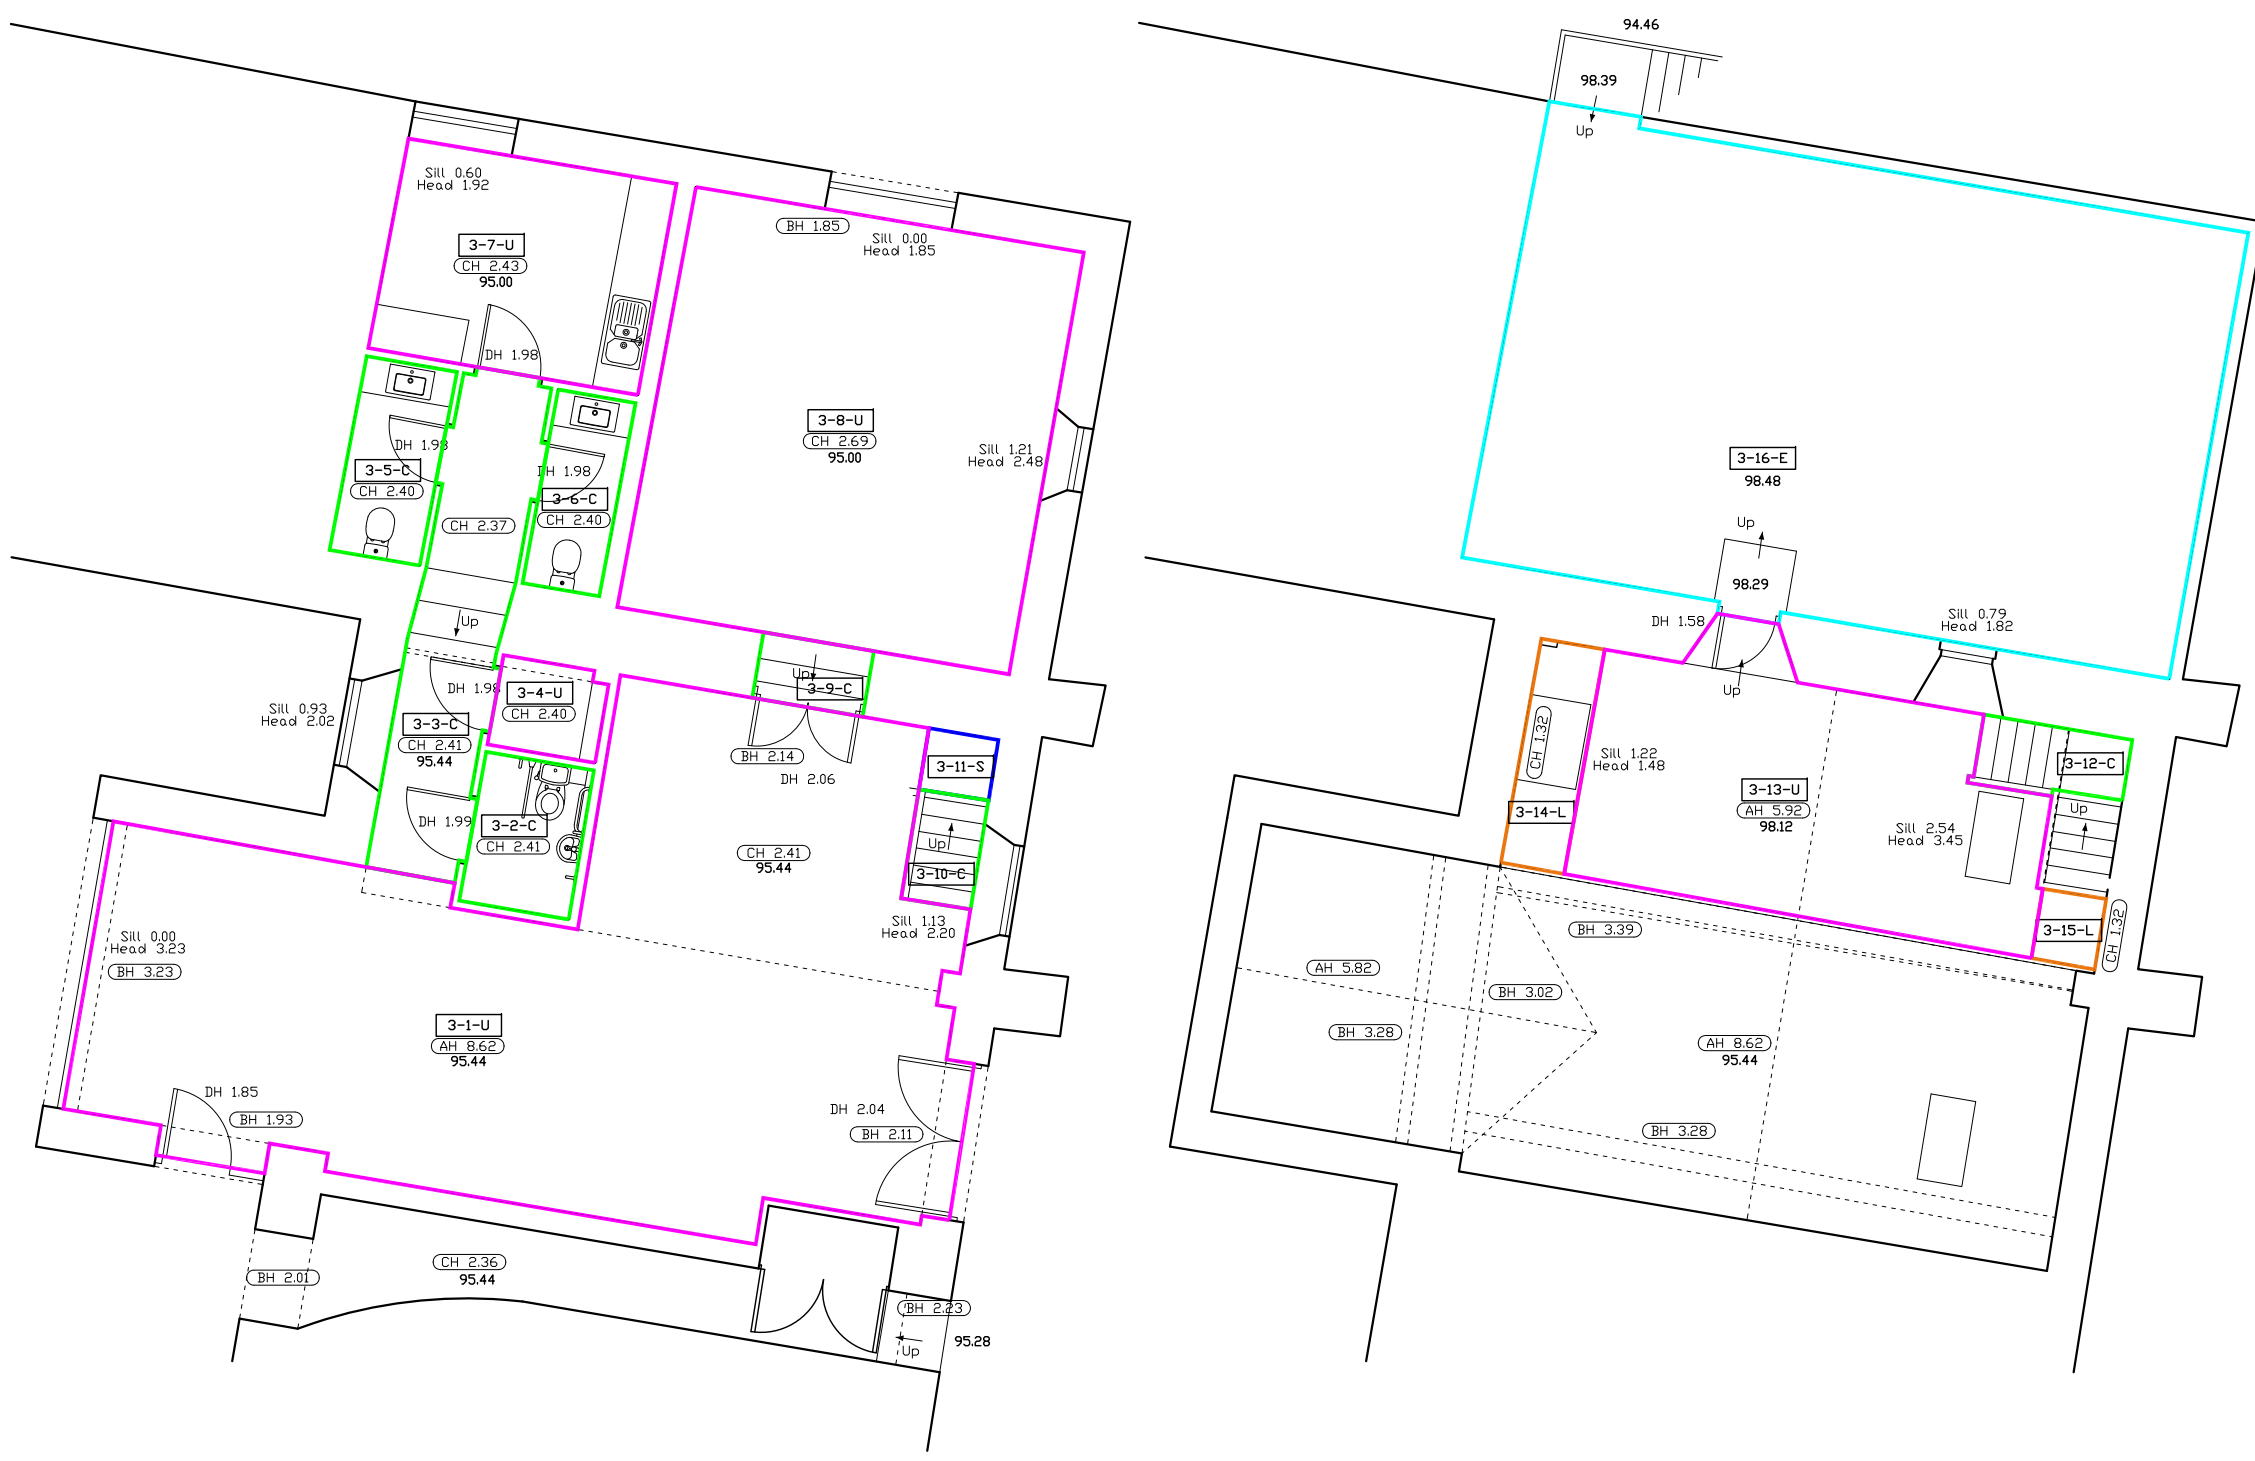

1 Ground Floor Plan

1:100

2 First Floor Plan

1:100

UNIT NUMBER - AREA - TYPE OF SPACE
 C = COMMON
 U = USABLE
 S = STORAGE
 L = LESS THAN 1.5m HEADROOM
 E = EXTERNAL

ABBREVIATIONS

- BH BEAM HEIGHT
- CH CEILING HEIGHT
- FCH FALSE CEILING HEIGHT
- FL FLOOR LEVEL
- AH APEX HEIGHT
- DH DOOR HEIGHT

A	Date	Revisions
---	------	-----------

© copyright retained

GOLDINGS

Chartered Building Surveyors
And Architectural Consultants

High Gables
Daglingworth
Cirencester
Glos. GL7 7AE

Tel. 01285 654975
Fax. 01285 641400

email: enquiries@goldingsurveyors.co.uk
web: www.goldingsurveyors.co.uk

Client
Prory Estates

Address
**Prory Court
Poulton
Gloucestershire
GL7 5JB**

Drawing Title
**Unit 3 -
Floor Plans -
As Built
With Area Classifications**

Scale
1:100 @ A3

Date
March 2017

Drawn by
I.J.G.

Drg. No.
0915 / 16 / 26

Rev.