

NOTES:
All dimensions for building work and built in items to be checked on site and not scaled from this drawing.

A	Date	Revisions
---	------	-----------

© copyright retained

GOLDINGS

Chartered Building Surveyors
And Architectural Consultants

High Gables
Daglingworth
Cirencester Tel. 01285 654975
Glos. GL7 7AE Fax. 01285 641400

email: enquiries@goldingsurveyors.co.uk
web: www.goldingsurveyors.co.uk

Client
Priory Estates

Address
**Priory Court
Poulton
Gloucestershire
GL7 5JB**


Drawing Title
**Unit 1 -
Floor Plans -
As Built
With Area Classifications**

Scale
1:100 @ A3

Date
March 2017


Drawn by
I.J.G.

Drg. No. 0915 / 16 / 22	Rev.
-----------------------------------	------

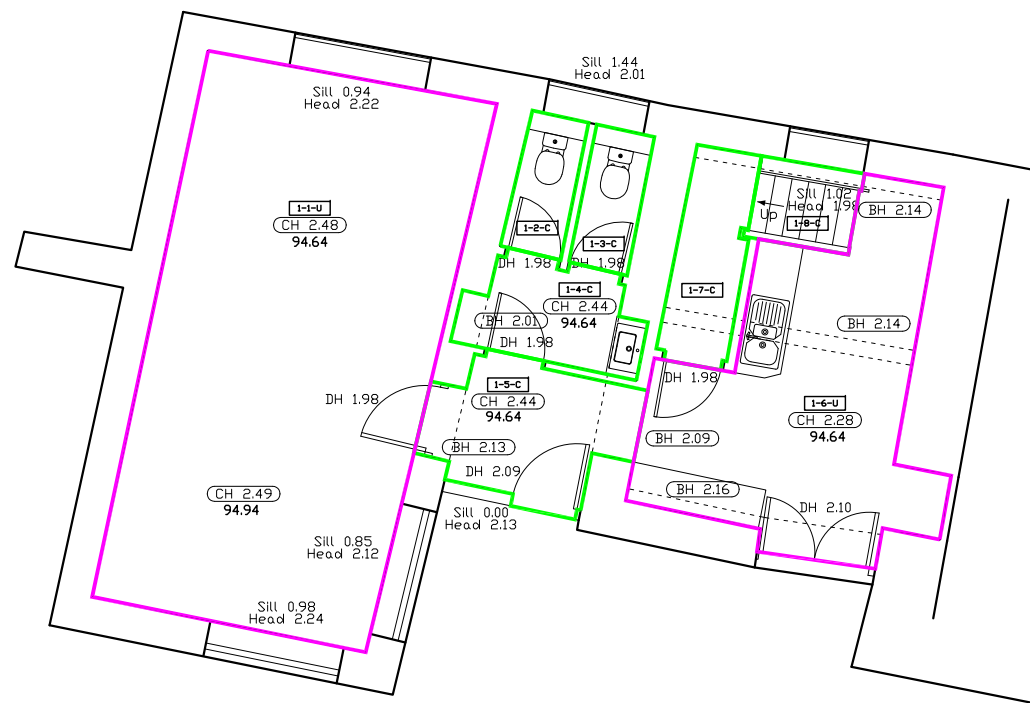

Ground Floor Plan

1
1:100

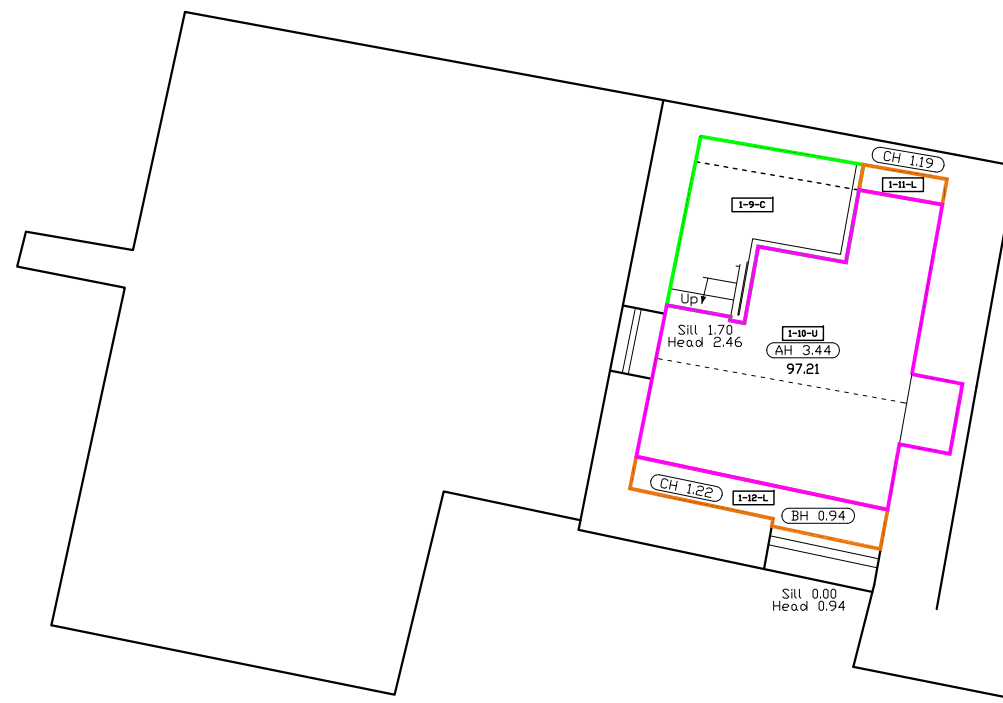

First Floor Plan

2
1:100

UNIT NUMBER - AREA - TYPE OF SPACE
C = COMMON
U = USABLE
S = STORAGE
L = LESS THAN 1.5m HEADROOM

ABBREVIATIONS

BH BEAM HEIGHT
 CH CEILING HEIGHT
 FCH FALSE CEILING HEIGHT
 FL FLOOR LEVEL
 AH APEX HEIGHT
 DH DOOR HEIGHT