



Site Areas

PREMISE AREA 2525m²
 GROSS EXT. BUILDING AREA 891m²
 ANCILLARY AREAS 243m²

PLAYING FIELD AREA 0m²
 CONSISTING OF:

TEAM GAME AREAS 0m²
 PERIPHERAL FIELD AREA 0m²

HARD PLAY AREA 309m²
 CONSISTING OF:

HARD GAMES COURTS 0m²
 HARD AREA INFORMAL 309m²


SOFT AREA INFORMAL 416m²

CAR PARKING AREAS 666m²

Block Description

- A Main Teaching Block I - -
- B Teaching Store J - -
- C Changing Shed K - -
- D Porta Cabin L - -
- E - - M - -
- F - - N - -
- G - - O - -
- H - -

B Verification of Site & Building 11/09/13AP
 A Verification of Site & Building 24/1/07HS

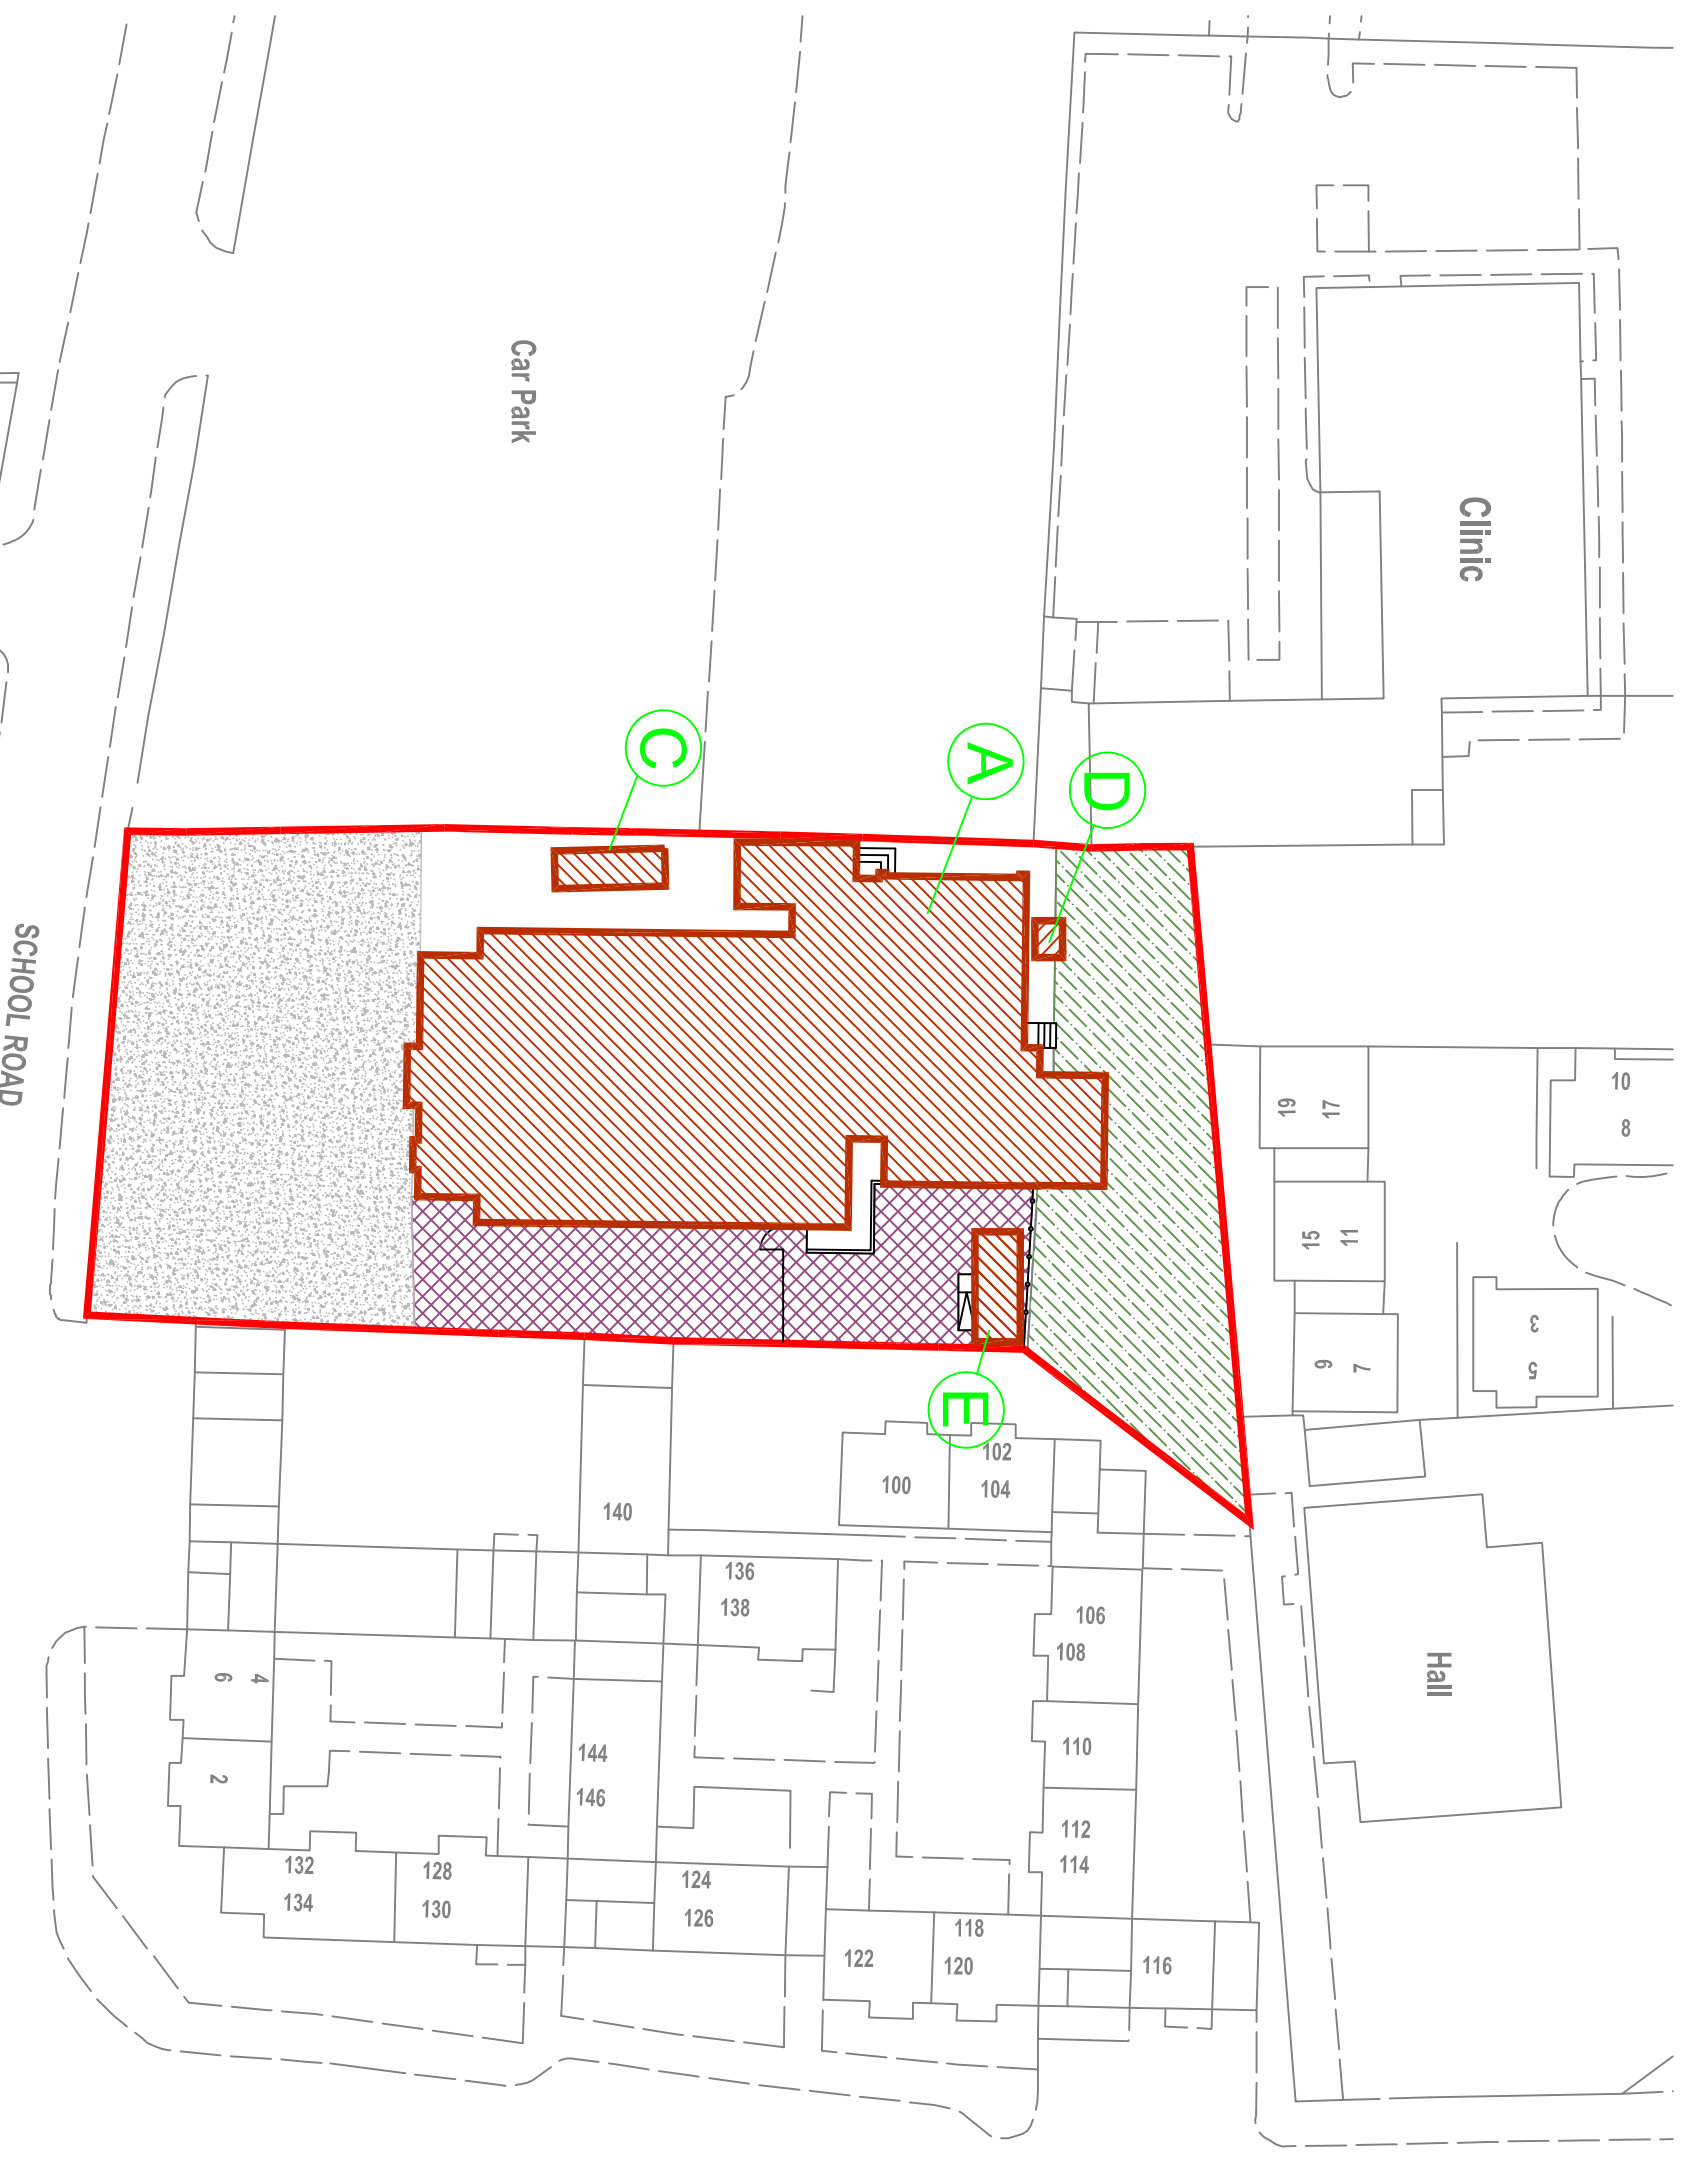


THE DARLEY CENTRE

SITE PLAN

PL(0)02B


As Built 1:500 12/10/05

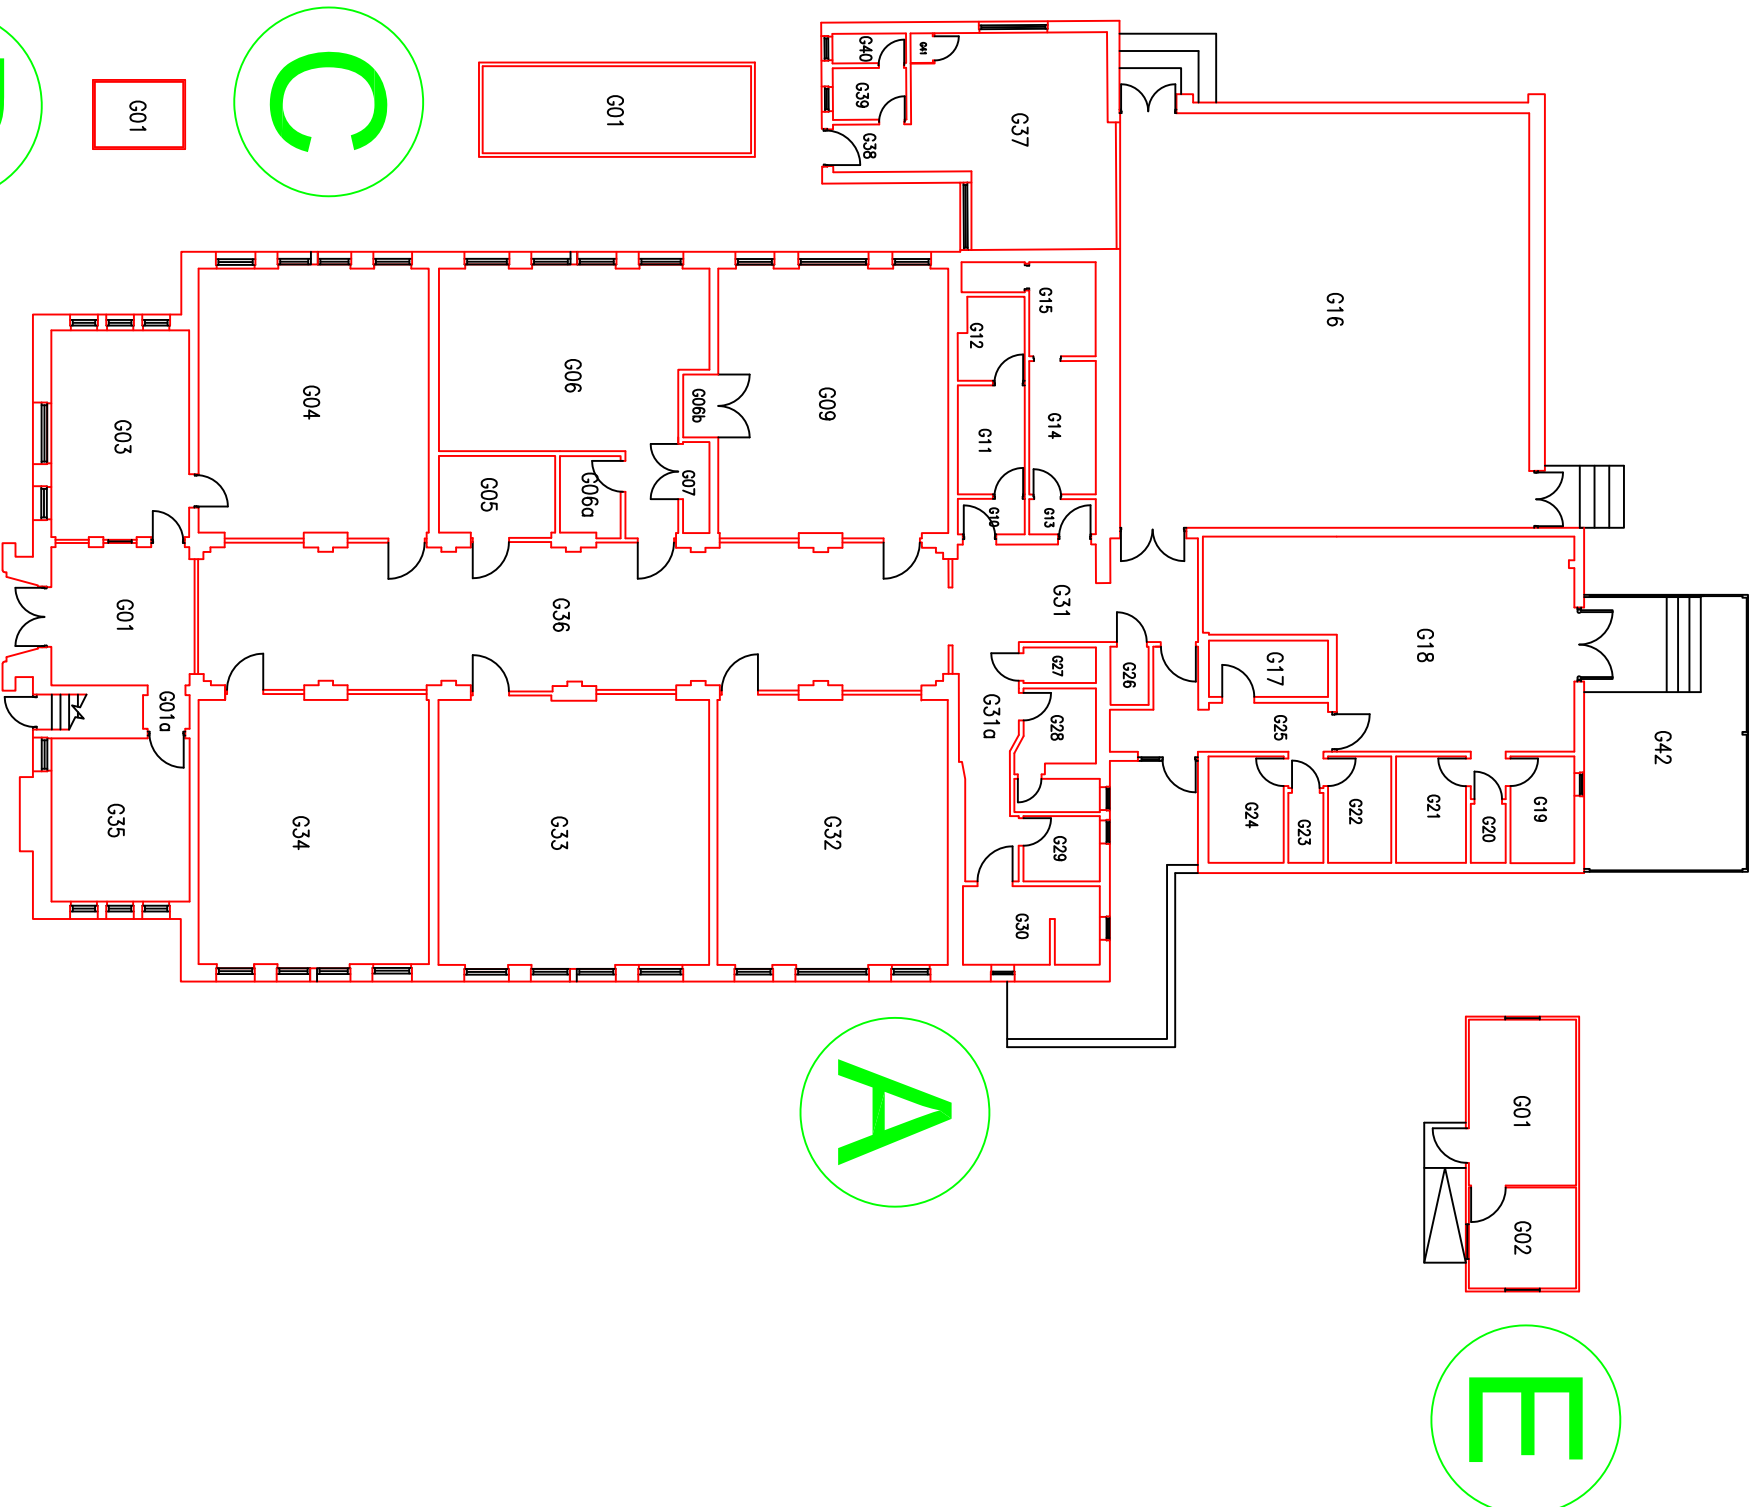

B Verification of Site & Building 11/09/13AP
 A Verification of Site & Building 24/1/07HS

THE DARLEY CENTRE
 LAYOUT PLAN
 GROUND FLOOR

As Built PA(2)01B
 1:200 12/10/05
 AM

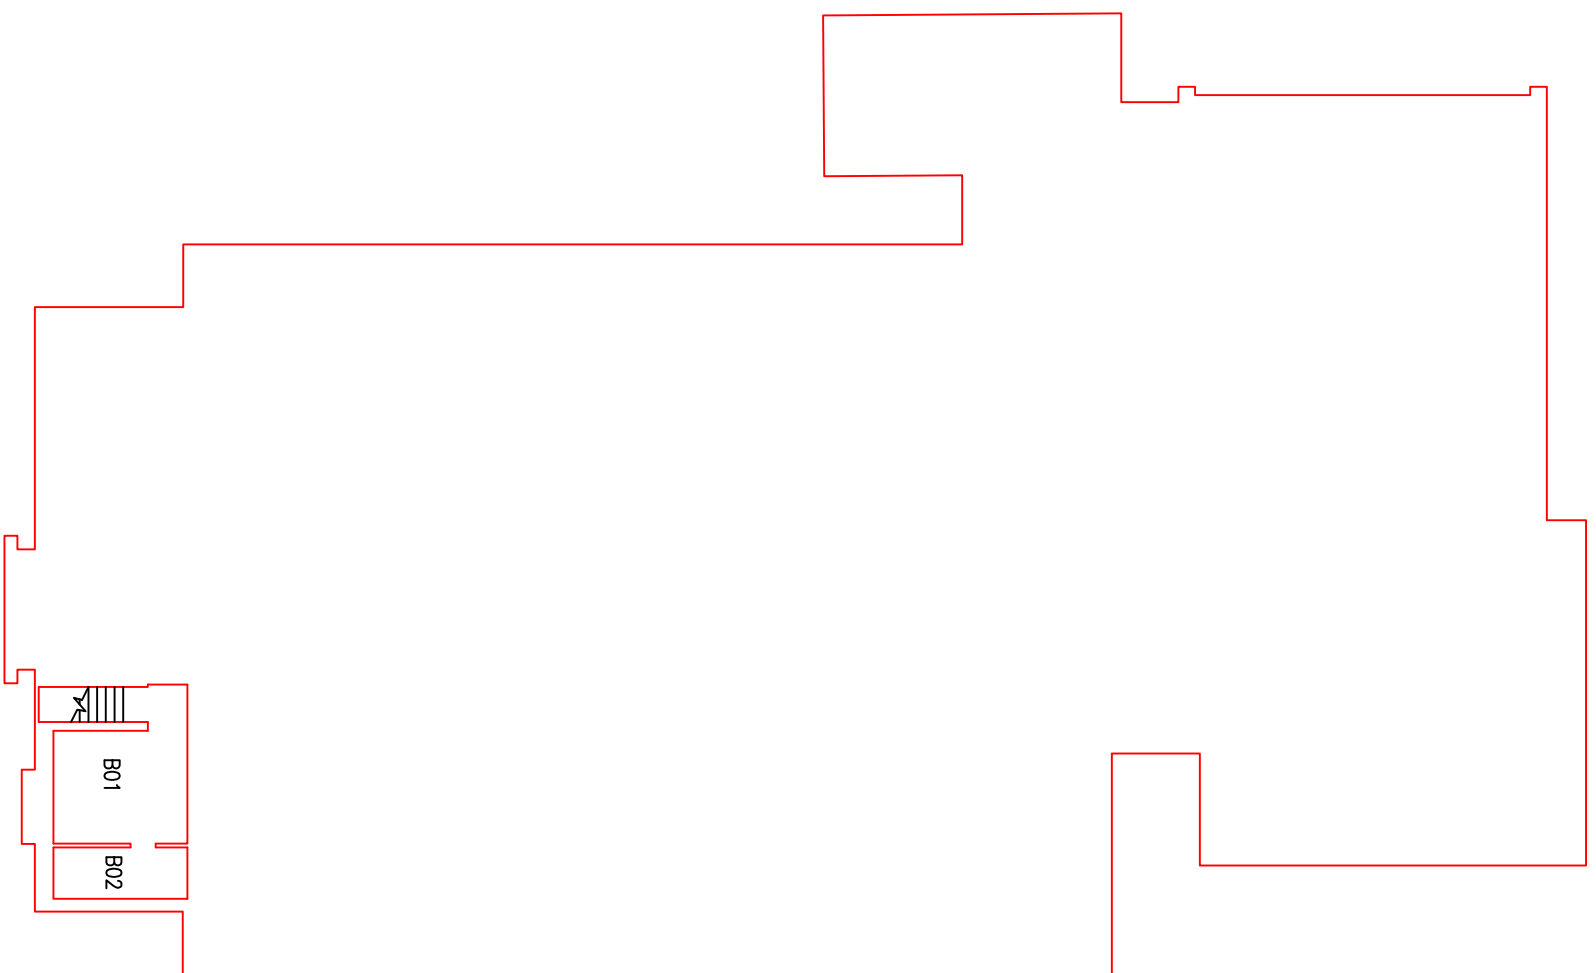

B Verification of Site & Building 11/09/13AP
A Verification of Site & Building 24/1/07HS

THE DARLEY CENTRE
LAYOUT PLAN
BASEMENT

— As Built PA(2)13B
AM 1:200 12/10/05