
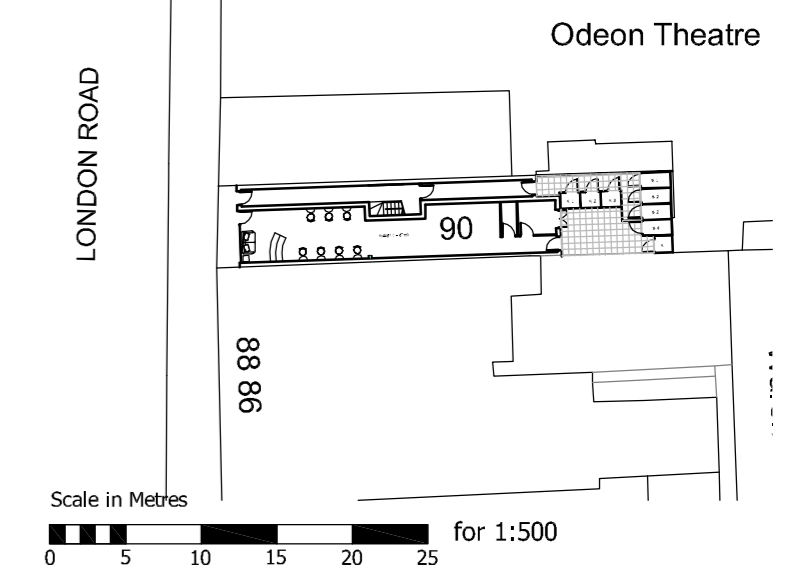
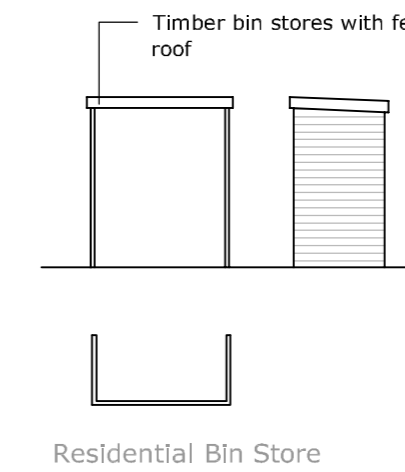


Scale in Metres for 1:1250

0 10 20 30 40 50 60


Proposed Ground Floor Layout

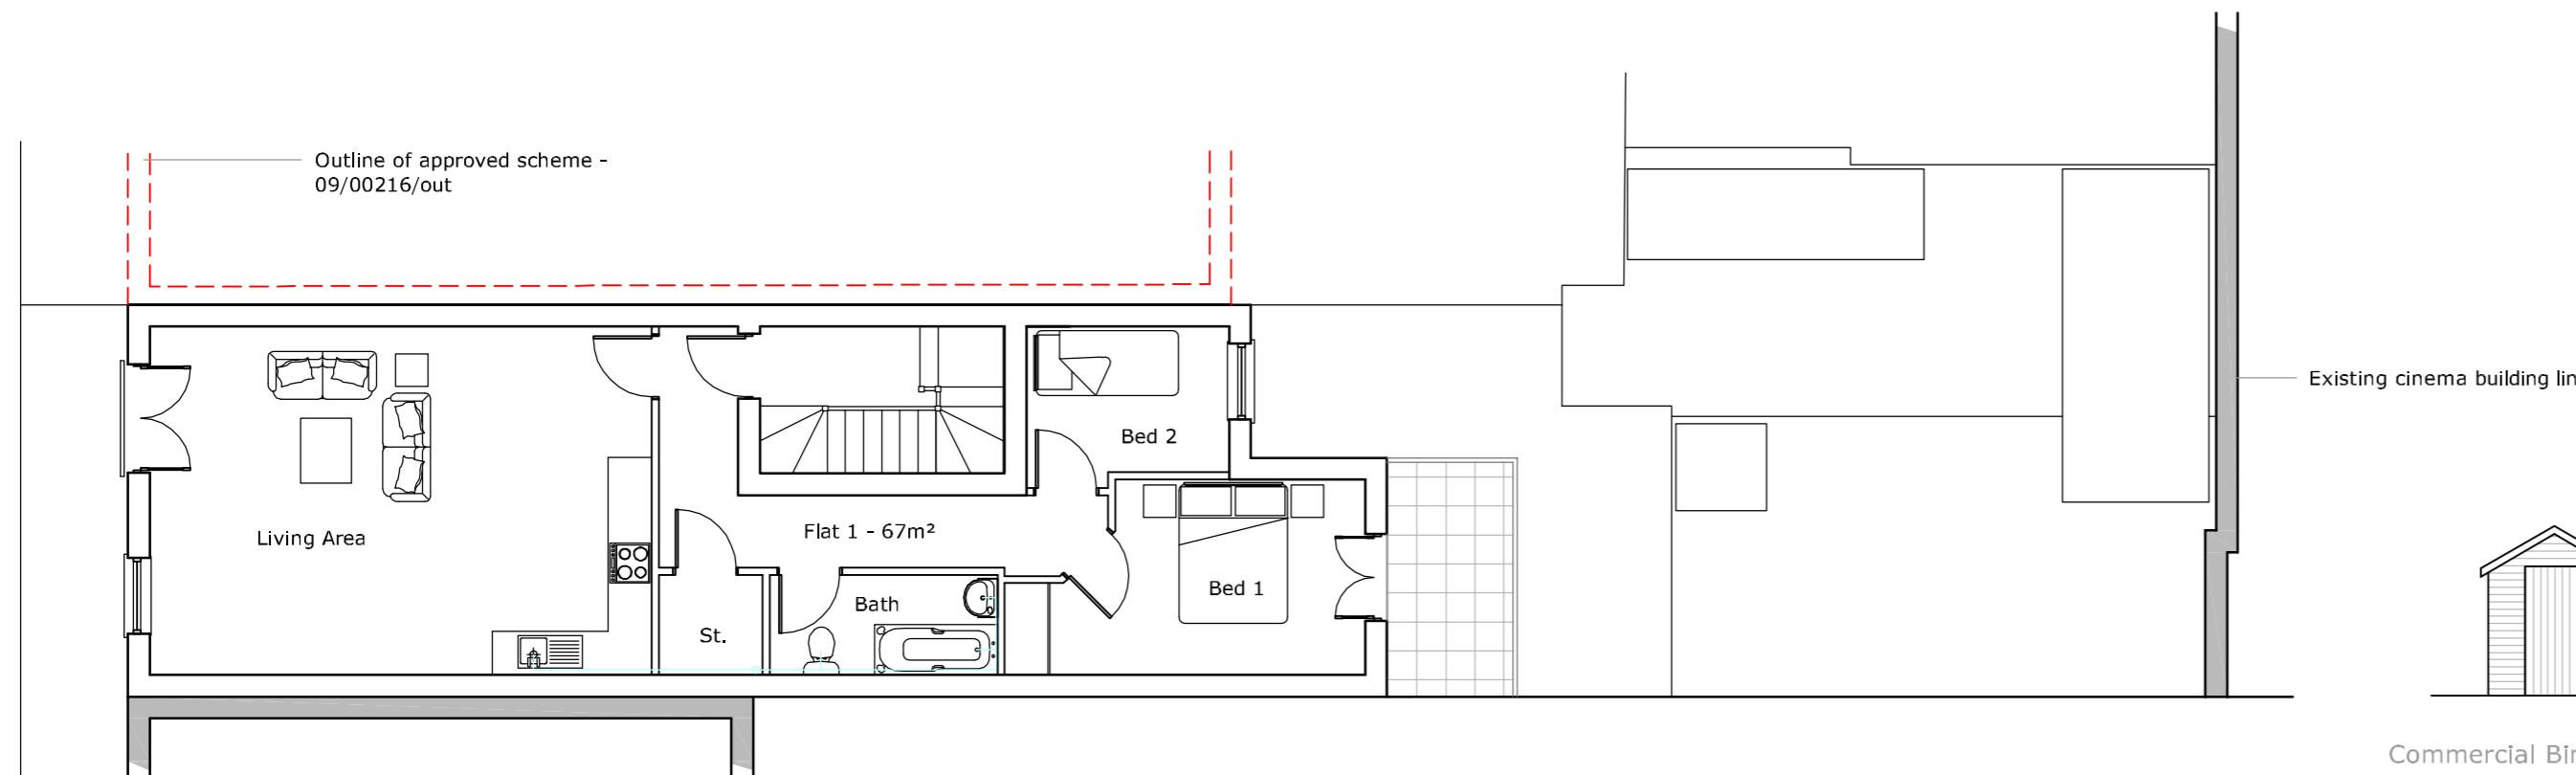

Scale in Metres for 1:500

0 5 10 15 20 25

Proposed First Floor Layout

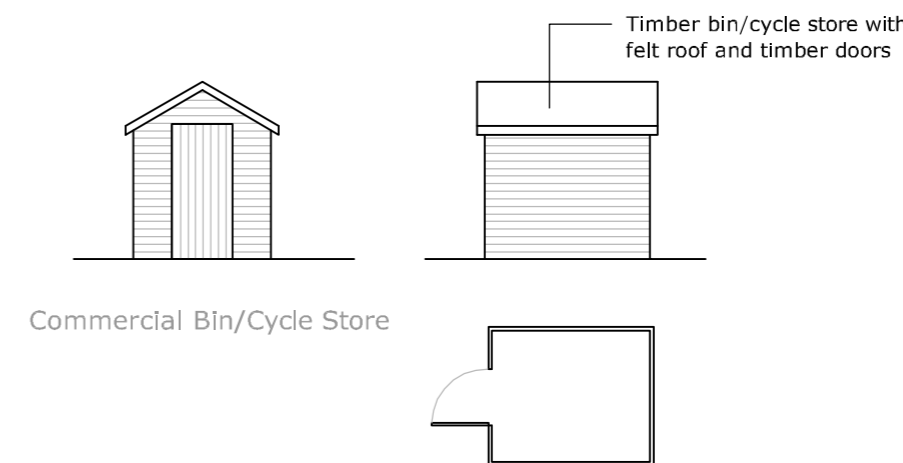


P4	25/11/11	Bin/Cycle Store elevations revised to accord with as built on site	JCB
P3	26/10/11	Bin/Cycle Store elevations added	JCB
Revision	Date	Description	Dwn Chkd


PLC ARCHITECTS

Brankesmere House
Queens Crescent, Southsea
Portsmouth PO5 3HT
Hampshire England
Tel: (023) 927 55 333
Fax: (023) 927 55 222
E-Mail: mail@plcarchitects.com
Web: www.plcarchitects.com

Client :

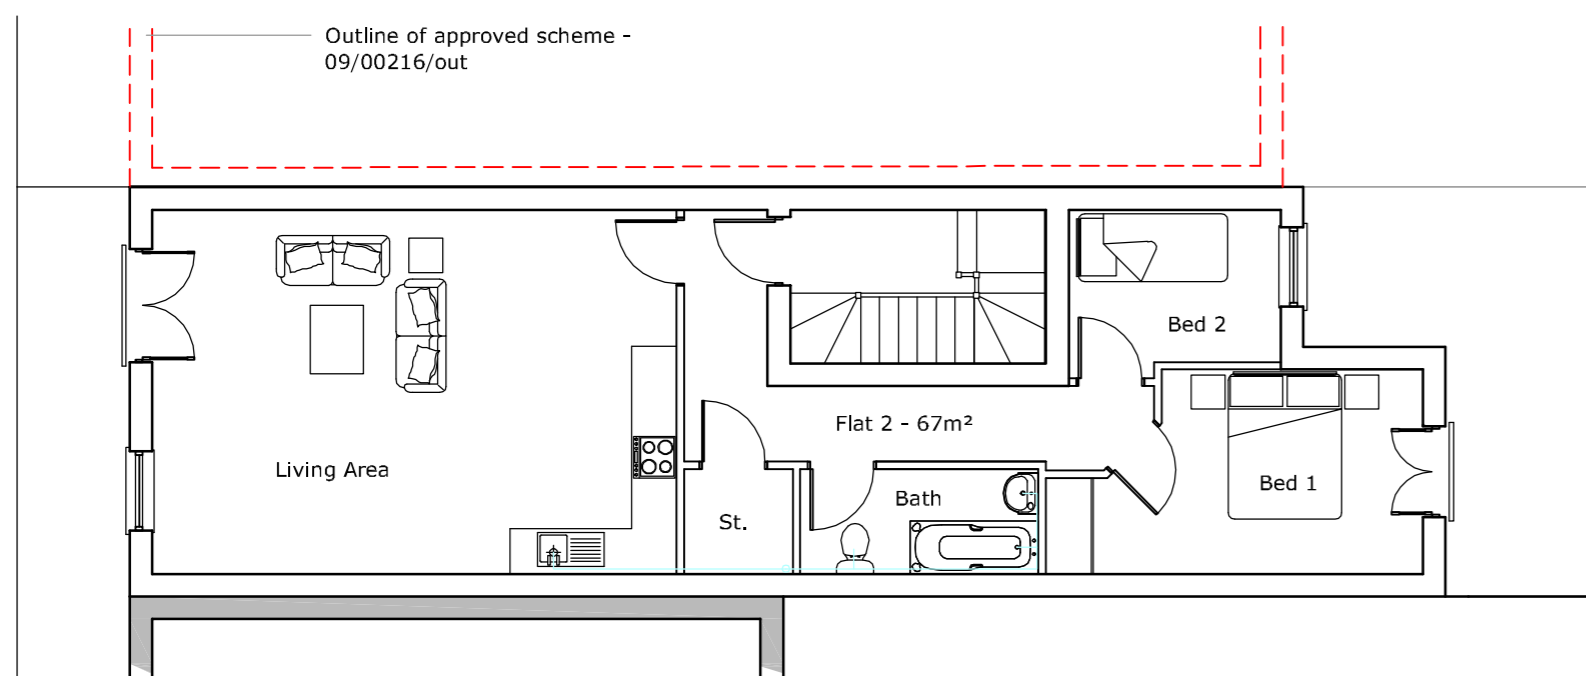

Proposed Second Floor Layout

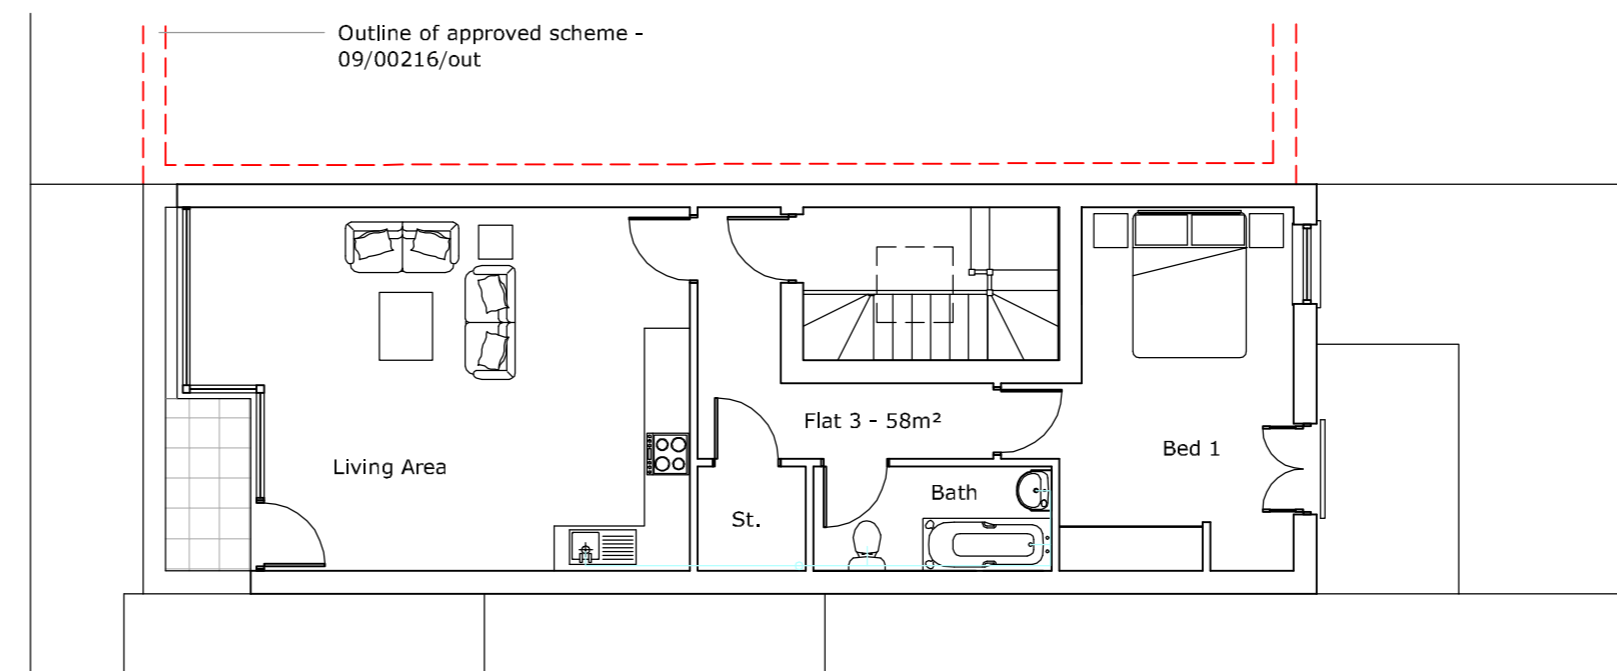

Proposed Third Floor Layout

Project :
Proposed Mixed Use Development
90 London Road, North End

Drawing Title :
Proposed Plans & external Stores

Drawn By	Date	Checked By	Date	Approved By	Date
JCB	Aug 09				

Drawing No.	Revision:	Scale:
09-1619-102	P4	1:100

PLC ARCHITECTS © COPYRIGHT RESERVED 2008
NOT TO BE SCALED. DIMENSIONS TO BE CHECKED ON SITE
SCALING ONLY FOR LOCAL AUTHORITY PURPOSES