



Millbank Care Home

Ref: 5771027

109 Millgate, Newark-on-Trent, NG24 4UA

Freehold: Offers Over £1,250,000

38 bedroom with 100% ensuite wet rooms

Prominent town centre location

Part grade II listed

Large purpose built extension

C2 Use

GIA 19,450 sq ft (sourced from EPC)




Millbank Care Home was formerly registered for up to 44 residents, presents an ideal opportunity for either existing C2 use (Care) or to redevelop for alternate use, subject to the necessary planning permissions.



Location

The home is located 0.3 miles from Newark town centre and is positioned on a residential street. Newark has two train stations and the main roads of Newark include the A1 and A46 as bypasses. The A17 runs east to King's Lynn, Norfolk, and the A616 north to Huddersfield, West Yorkshire.

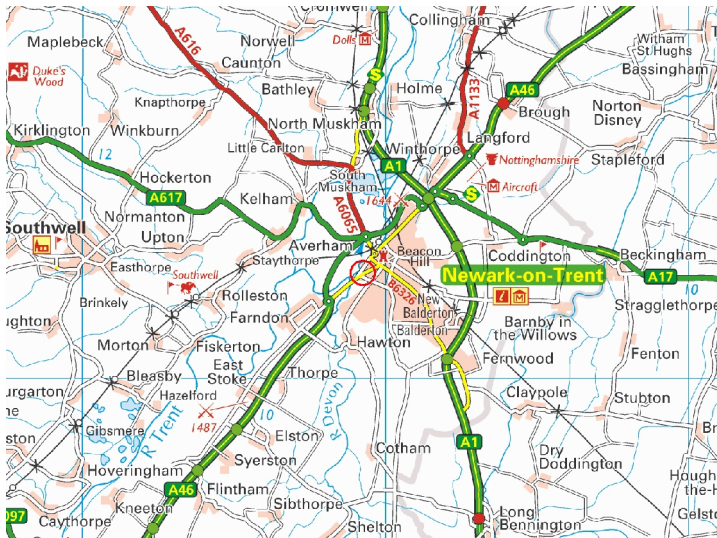


Description

The home underwent an extensive modernisation in 2013, which resulted in most rooms being above 12 sqm and all rooms becoming wet rooms. The home benefits from a lift in the property, on top there are small platform to connect the corridors that differ in height with ancillary accommodation. The bedrooms range from 12-21 m2 excluding the wetroom measurements.

Internal Details

Basement Four Rooms including Boiler Room
Second/Attic Floor One Bedroom, Shower Room/WC, Kitchen area and Staff Room



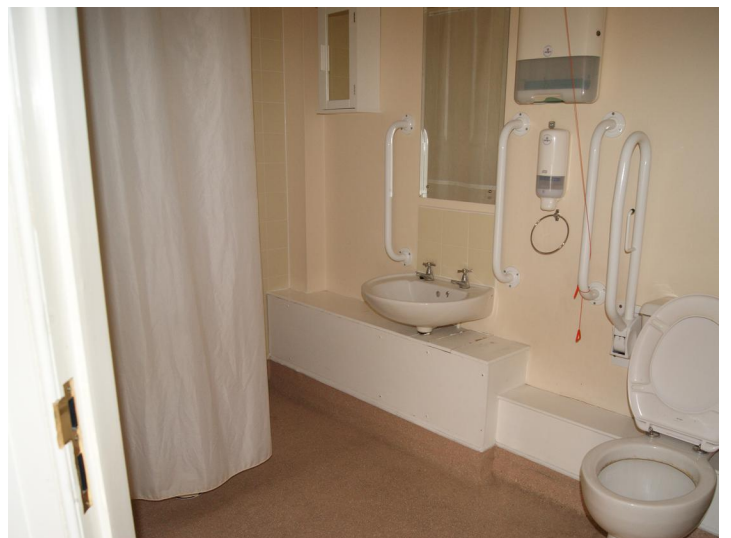

Ground Floor

Ground Floor
Communal Entrance Hall
Nineteen Bedrooms with wetrooms

Two Lifts (not tested)
Dining Rooms/Lounges
Communal Kitchen
further Kitchen area
Two further communal Entrance Halls
ancillary accommodation

Other Floors

First Floor
Eighteen Bedrooms each with wetrooms, further Communal Lounge and a
Communal Dining/Kitchen, WCs and ancillary accommodation



Christie Finance is an independent finance broker recommended by Christie & Co. For full information on the finance options available for this business or any other, please call 0344 412 4944.



For full information on Christie Insurance please call 03330 107189



DO NOT SCALE THIS DRAWING. THE CONTRACTOR IS LEGALLY RESPONSIBLE FOR CHECKING ALL DIMENSIONS ON SITE AND REPORTING ANY DISCREPANCIES TO THE ARCHITECT IMMEDIATELY. THE CONTRACTOR IS RESPONSIBLE FOR OBTAINING ALL NECESSARY PERMITS AND COMPLIANCE WITH ALL RELEVANT REGULATIONS AND STANDARDS. 

Fire Safety Details	

Ogilby & Linn Ltd
 Chartered Architects
 Suite 2.1 The Park
 12 Market Street, Nottingham
 Tel: 0115 837 7618
 email: info@ogilbylinn.co.uk



Client: **Heritage Care**

Project: **Alterations and Extensions to Existing Care Home at Millbank, 109 Mill Gate, Newark, Notts**








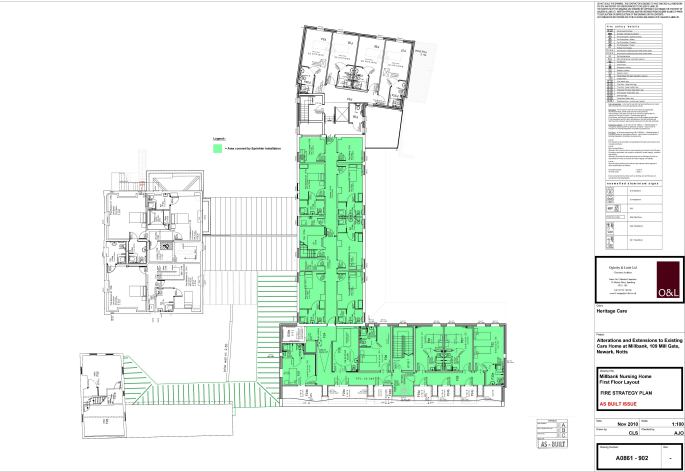













Customer Due Diligence Checks

The Money Laundering, Terrorist Financing and Transfer of Funds (Information on the Payer) Regulations 2017 (as amended) require us to conduct due diligence checks upon all purchasers. When an offer has been accepted, the prospective purchaser(s) will need to provide, as a minimum, proof of identity and residential address; if the purchaser is a company or other legal entity, then any person owning more than 25% must provide the same. These documents must either be handled and copied by a Christie & Co employee, or certified copies be provided.

Contact

No direct approach may be made to the business. For an appointment to view, please contact the vendor's agent:

Rosie Turner

Senior Business Agent
M:+44 7703 716 156
E:rosie.turner@christie.com
Nottingham

Lee Howard

Regional Director
M:+44 7764 241 339
E:lee.howard@christie.com
Nottingham

These particulars are a general guide to the property and are not to be relied on as statements or representations of fact. Purchasers should instruct professional advisers and rely on their own searches, enquiries and inspections regarding the property and any associated business. Neither Christie & Co nor any employee is authorised to give any representation or warranty regarding the property. Christie & Co for itself and for its client gives notice that: (a) these particulars are made without responsibility on the part of Christie & Co or the client and do not constitute any part of an offer or contract; (b) Christie & Co has not conducted a detailed survey or tested services, appliances or fittings; and (c) any dimensions, floor plans and photographs provided are for indicative purposes only. July 2024